

**Sewage System Installation Report**


File Number: V-12-09

Installation by: LYLE EMBURY Date: 09-11-17

Work authorized by Site Inspection Report for a Sewage System Permit has been satisfactorily completed and includes:

1. Septic Tank/Holding Tank of working capacity of 4500 litres constructed of plastic/concrete/fibreglass  
Manufacturer: BCP
2. Distribution Pipe: Type: PVC Absorption Trench System  Filter Bed System   
Filter Bed Area: 37 m<sup>2</sup> Filter Sand Contact Area 37 m<sup>2</sup>  
Total 40 Linear Metres in 8 runs of 5 metres and fed by: Gravity  Siphon  or Pump   
Loading Rate Area: N/A m<sup>2</sup> 15 metre constructed mantle provided: Yes /  (circle)
3. Size of System based on 2 bedrooms and/or 19 fixture units. Commercial details: \_\_\_\_\_  
Area of Building: 213 m<sup>2</sup> Total Daily Design Sewage Flow: 1300 litres
4. Other 8' - 14'

Diagram of Installation as observed by Inspector:

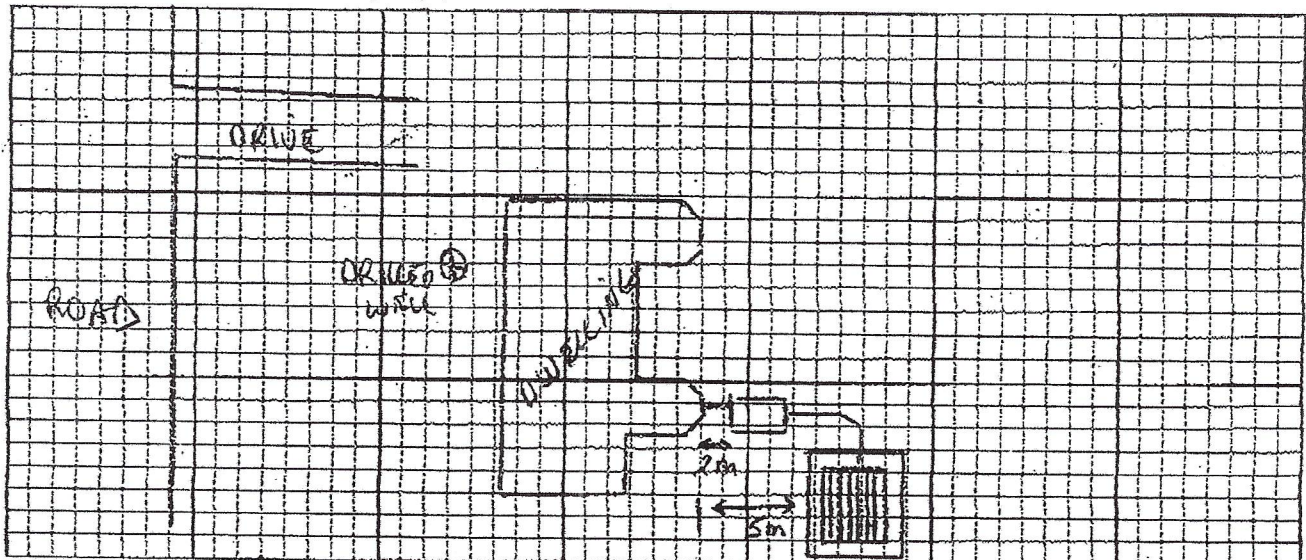

Ensure the following work is completed: 1) Backfill system and sod or seed 2) Stabilize all sloped surfaces 3) Finish grading to shed run-off and divert water around leaching bed 4) If a pump is used after the tank, ensure the weeping tile are dosed to 75% capacity in 15 minutes and include a high level alarm in case of pump failure.

Comments: MAINTAIN EFFLUENT FILTER  
ADDITIONAL STREET REQ DONE 09-12-01

**INSTALLATION REPORT**

Under the Building Code Act and regulations, and subject to the limitations thereof, a permit is hereby issued to: JASON SZAKACSI

For the use and operation of the Class 4 Sewage System Installed/Altered under Site Inspection Report # V-12-09

Such system being located on Lot #: 2 Conc. #: 10 Plan #: 57M-759 Sub Lot#: 3

Civic (Emergency, Fire, 911) # 112 Street: PELLER CT

Roll # \_\_\_\_\_ Township/County/City: VERA LUM

Inspected & Recommended by (Appointed Inspector - Part 8): [Signature] Date: 09-11-17

Reviewed (Part 8 Coordinator): [Signature] Date: 09-12-01