



Sewage System Installation Report

File No. SS2021-0305
Roll No. 165116005041300

Sewage System Installation by: Bagshaw Excavating Date: June 24, 2021

Approved Installation of the Sewage System includes:

- ☐ New ☐ Repair/Alteration ☒ Replacement ☒ Tank ☐ Leaching Bed ☐ Tank & Leaching Bed
- ☐ Class 2 or 3 System: Size: _____ m² Configured As: Length _____ m x Width _____ m x Height _____ m
Wall Structure: _____ Type of Cover: _____
- ☐ Class 5 System: Holding Tank: _____ L Manufacturer: _____ ☐ Audible & Visual Alarm
- ☒ Class 4 System:
- ☒ Septic Tank: Working Capacity 3600 L constructed of concrete/fiberglass/plastic; Manufacturer: NPCP
- ☒ Distribution System: Unknown; fed by ☒ Gravity ☐ Pump ☐ Siphon

<input type="checkbox"/> Conventional Trench System: Total _____ Lineal Metres in _____ runs of _____ m	<input type="checkbox"/> Type A Dispersal Bed/Area Bed: Stone Area _____ m ² Sand Area _____ m ²
<input type="checkbox"/> Filter Bed: Filter Bed Area _____ m ² # of Pods _____ Expanded Contact Area _____ m ²	<input type="checkbox"/> Type B Dispersal Bed: DBA _____ m ² Linear Loading Rate _____ m Configured As: _____ m x _____ m

- ☐ Loading Rate Area: _____ m² ☐ Imported ☐ Native ☐ 15 metre Mantle ☐ Constructed ☐ Native ☐ Not Applicable
- ☐ Height of Stone/Chamber Raised Above Original Grade: _____ m ☐ Other: _____


Sewage System Installation is based on:

Total Daily Sewage Flow: 1600 L/day

☒ No. of Bedrooms: 3; Total No. of Fixture Units 17.5; Total Living Space 4200 m²

☐ Commercial: _____

☒ Sewage System is not designed to receive backwash water from a water treatment device.

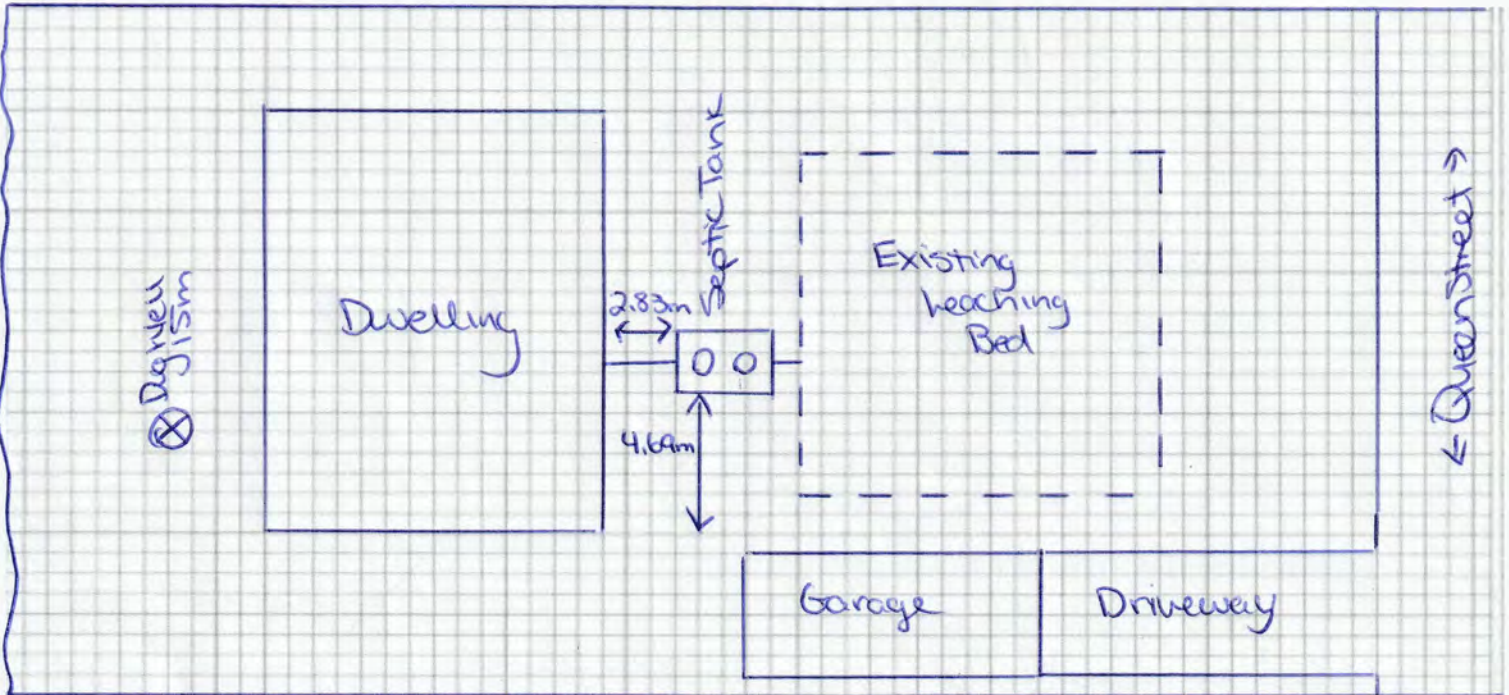

Under the Building Code Act, Ontario Regulation 332/12 as amended and subject to the limitations thereof, an Installation Permit is hereby issued to: _____ for the use and operation of the above-noted sewage system installed and inspected at: 19 Queen Street also known as Lot _____ Concession _____ Plan 15 Sublot/Part: 35 in the City of Kawartha Lakes. Queen E.

Inspected and Issued By: Jessica Lee Date: July 16/21

Note: No change can be made to any building(s) or structures in connection with which this sewage system is used, if the operation or maintenance of the sewage system will be effected, unless approval is obtained.