

Sewage System Installation Report


File Number: C-03-13

Installation by: DAVE DOBINSON EXCAVATING Date: OCT. 2, 2013

Work authorized by Site Inspection Report for a Sewage System Permit has been satisfactorily completed and includes:

1. Septic Tank/Holding Tank of working capacity of 3600 litres constructed of plastic/concrete/fibreglass
Manufacturer: ORILUA PRECAST Model: _____
2. Distribution Pipe: Type: INFILTRATOR Absorption Trench System ☐ Filter Bed System ☒
Filter Bed Area: 26.5 m² Filter Sand Contact Area 26.5 m²
Total 20.72 Linear Metres in 4 runs of 5.18 metres and fed by: Gravity ☒ Siphon ☐ or Pump ☐
Loading Rate Area: 160 (NATIVE) m² 15 metre constructed mantle provided: Yes / No (circle) NATIVE
3. Size of System based on 3 bedrooms and/or <20 fixture units. Commercial details: N/A
Area of Building: 200 m² Total Daily Design Sewage Flow: 1600 litres
4. Other BOTTOM OF CHAMBER IS 0.46m ABOVE ORIGINAL GRADE.

Diagram of Installation as observed by Inspector:

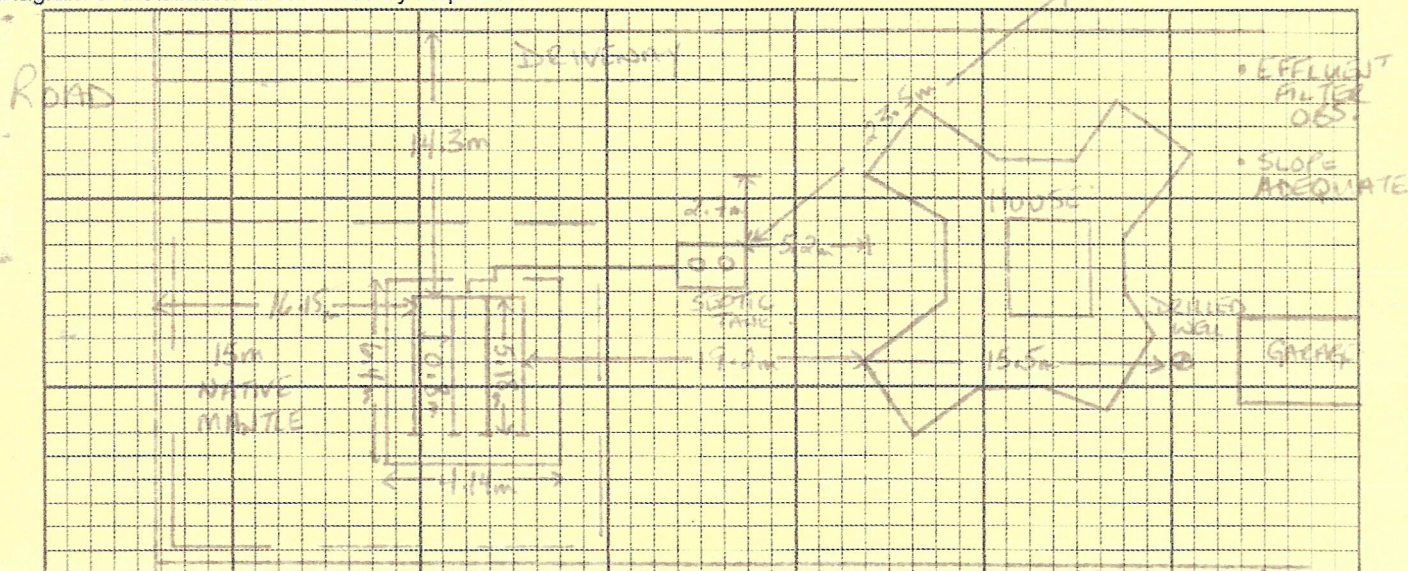

Ensure the following work is completed: 1) Back fill system and sod or seed 2) Stabilize all sloped surfaces 3) Finish grading to shed run-off and divert water around leaching bed 4) If a pump is used after the tank, ensure the weeping tile are dosed to 75% capacity in 15 minutes and include a high level alarm in case of pump failure.

Comments: SEWAGE SYSTEM IS NOT DESIGNED TO RECEIVE BACKWASH WATER FROM A WATER TREATMENT DEVICE (WATER SOFTENER, ETC).

INSTALLATION REPORT

Under the Building Code Act and regulations, and subject to the limitations thereof, a permit is hereby issued to:

For the use and operation of the Class 4 Sewage System Installed/Altered under Site Inspection Report # C-03-13

Such system being located on Lot #: PT. 17 Conc. #: 3 Plan #: N/A Sub Lot #: N/A

Civic (Emergency, Fire, 911) # 284 Street: LAKE DALRYMPLE ROAD

Roll # N/A Township/County/City: CARDEN / CKL

Inspected & Recommended by (Appointed Inspector - Part 8): [Signature] Date: OCT. 9, 2013

Reviewed (Part 8 Coordinator): [Signature] Date: October 9, 2013