



Haliburton, Kawartha, Pine Ridge District

Health Unit


Sewage System Installation Report

File Number: F-07-13Installation by: SHEPHERD ENTERPRISES INC. Date: AUGUST 9, 2013

Work authorized by Site Inspection Report for a Sewage System Permit has been satisfactorily completed and includes:

1. Septic Tank/Holding Tank of working capacity of 3600 litres constructed of plastic/concrete/fibreglass
Manufacturer: ARMTEC-BCP
2. Distribution Pipe: Type: PVC Absorption Trench System ☐ Filter Bed System ☒
Filter Bed Area: 24.5 m² Filter Sand Contact Area 100.1 m²
Total 36 Lineal Metres in 6 runs of 6 metres and fed by: Gravity ☐ Siphon ☐ or Pump ☒
Loading Rate Area: 316.0 m² 15 metre constructed mantle provided: Yes / No (circle)
3. Size of System based on 3 bedrooms and/or <20 fixture units. Commercial details: N/A
Area of Building: <200 m² Total Daily Design Sewage Flow: 1600 litres
4. Other BOTTOM OF STONE LAYER IS 0.75m ABOVE ORIGINAL GRADE.

Diagram of Installation as observed by Inspector:

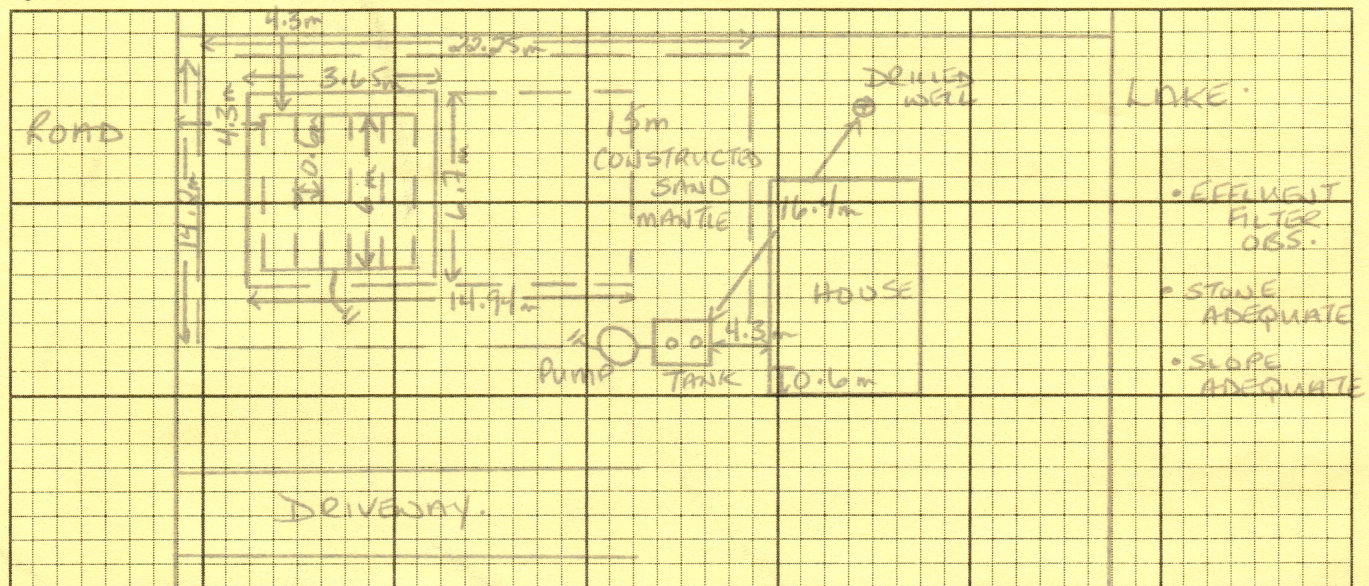

Ensure the following work is completed: 1) Backfill system and sod or seed 2) Stabilize all sloped surfaces 3) Finish grading to shed run-off and divert water around leaching bed 4) If a pump is used after the tank, ensure the weeping tile are dosed to 75% capacity in 15 minutes and include a high level alarm in case of pump failure.

Comments: SEWAGE SYSTEM IS NOT SIZED TO RECEIVE BACKWASH WATER FROM A WATER TREATMENT DEVICE (WATER SOFTENER, ETC).

INSTALLATION REPORT

Under the Building Code Act and regulations, and subject to the limitations thereof, a permit is hereby issued to:

JAMES CRANDALLFor the use and operation of the Class 4 Sewage System Installed/Altered under Site Inspection Report # F-07-13Such system being located on Lot # Pt. 27 Conc. #: 3 Plan #: 223 Sub Lot #: 18Civic (Emergency, Fire, 911) # 56 Street: JASPER DRIVE.Roll # 1651 210 02029900 0000 Township/County/City: FENELON / CKLInspected & Recommended by (Appointed Inspector - Part 8): [Signature] Date: Aug. 26/13Reviewed (Part 8 Coordinator): [Signature] Date: Sept. 3, 2013

EH-LC-145-01

R-04

R-05

Note: No change can be made to any building(s) or structures in connection with which this sewage system is used, if the operation of effectiveness of the sewage system will be affected by the change, unless a Sewage System Permit is obtained.